


AS INSTALLED FRONT ELEVATION

Scale 1:50

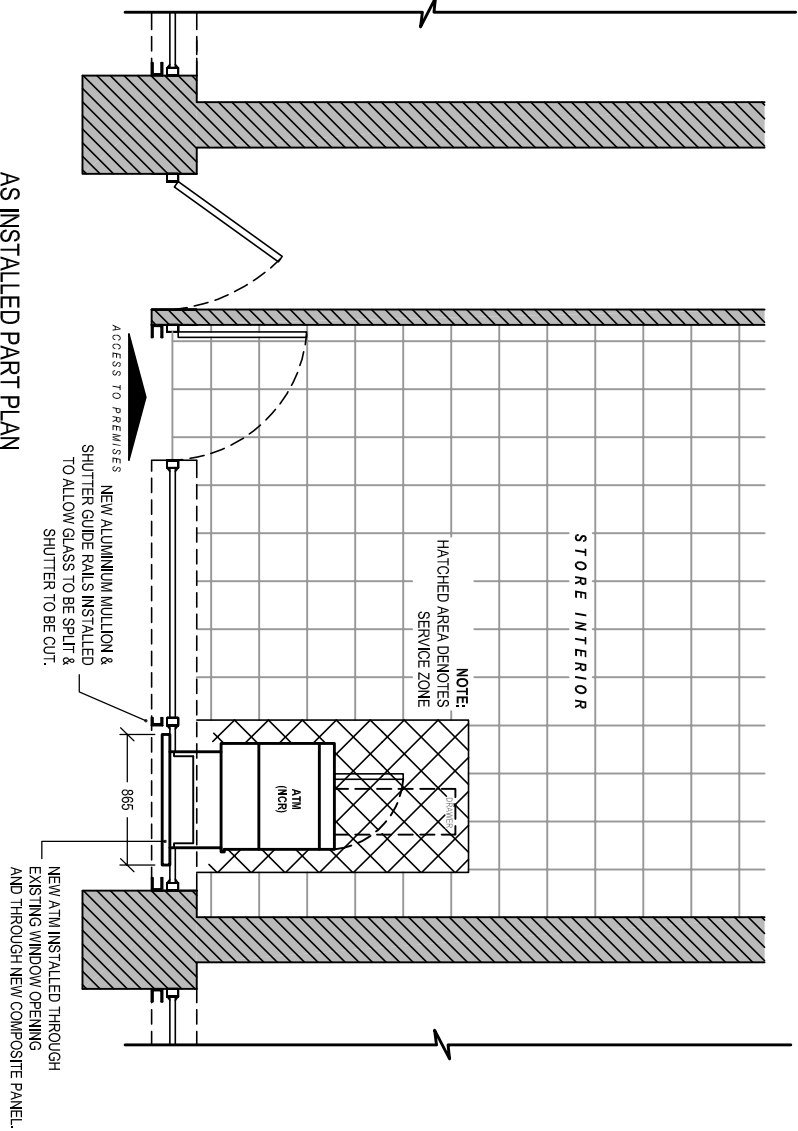

AS INSTALLED PART PLAN

Scale 1:50

Date: _____ By: _____

Comments: _____

GENERAL NOTES:
1) All dimensions in millimeters unless otherwise stated.

Site:
FIVEWAYS DISCOUNT STORE
9 Childwall Valley Road
Liverpool
L16 4PB

Drawing Title:
As Installed Elevations and Plans

Ref: NM-10-2015-106-2	Date: 31-10-2015	Rev:
Scale: 1:50	Paper: A3	Date Rev: