


Typical gate details - applies to service area and car parking access

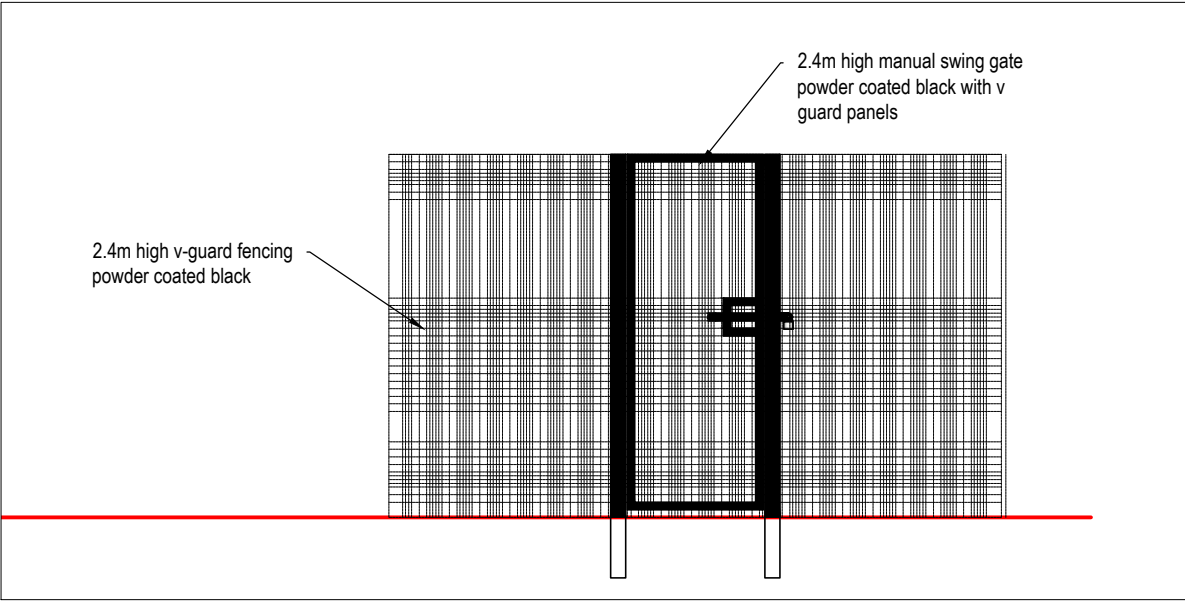

Typical pedestrian gate details

COPYRIGHT RESERVED

Notes

Revisions

Rev	Date	Descriptions
A	JULY 15	REVISED TO AS BUILT STATUS

BUILDING MANAGEMENT SERVICES LTD

Huddersfield Road  
Elland, West Yorkshire  
HX5 9BW  
TELEPHONE : ELLAND (01422) 371616  
FAX No : (01422) 376717  
Email mail@bmselland.com

**Building Management Services**

Client

C.D.P. LIMITED

Project

INDUSTRIAL DEVELOPMENT  
LIVERPOOL BUSINESS PARK  
IIVERPOOL

Sheet

TYPICAL GATE DETAILS

Drawn	B.D.L.	Date	SEPT 2016
Scales	1:50 @ A3		
Drawing No		M2987-102	