




1 ELEVATION - PROPOSED FRONT  
SCALE 1:50 @ A1

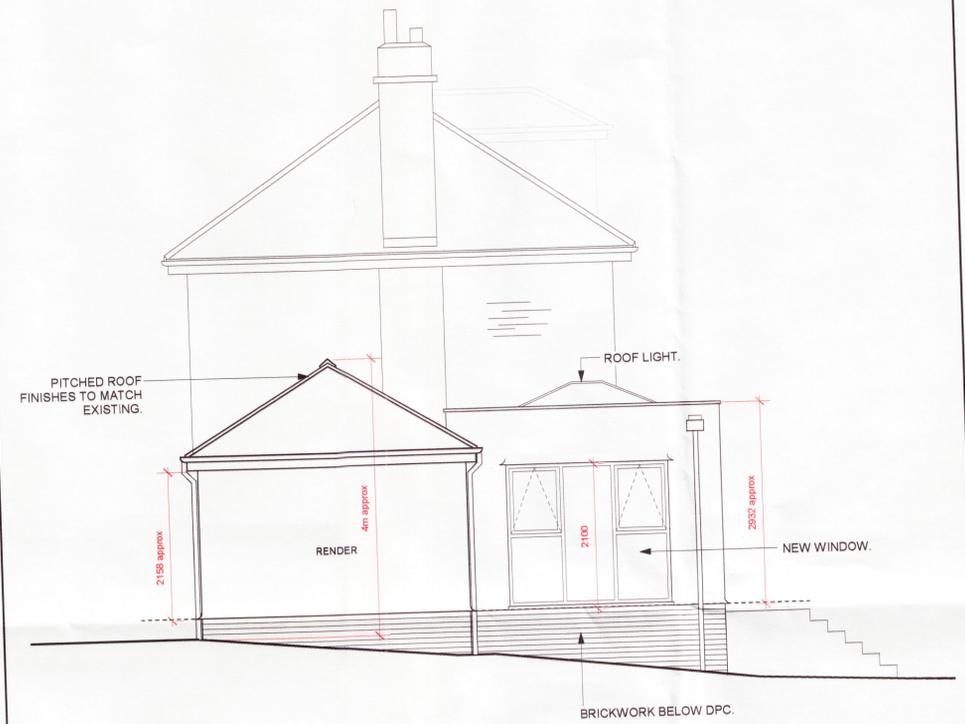


3 ELEVATION - PROPOSED SIDE  
SCALE 1:50 @ A1

15/2/1030  
22/4/15



2 ELEVATION - PROPOSED REAR  
SCALE 1:50 @ A1

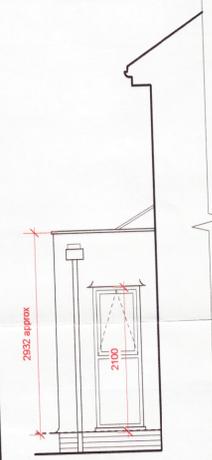

4 ELE - PROP' SIDE  
SCALE 1:50 @ A1

**PLEASE NOTE:**  
The information is subject to relevant statutory approvals.  
© This drawing is copyright of Awake Architects Ltd. and may not be reproduced in any way without their specific permission. Awake Architects is a Limited Liability Company registered in England and Wales (Reg No 6488638) Registered address: 44 Garston Old Road, Grassendale, Liverpool, Merseyside, England L19 9AF.

REV	DATE	DESCRIPTION	BY
B	07-04-15	Plans amended to comply with PD guidance. Extension roof hipped.	MC
A	11-10-14	Roof design amended.	MC
OP:	OUTLINE		
PL:	PLANNING		
BR:	BUILDING REGULATIONS		
TI:	TENDER		
CI:	CONSTRUCTION		
AB:	AS BUILT		

CLIENT	Mr. & Mrs. Winstanley.		
LOCATION	105 Druids Cross Road, L18.		
PROJECT	Single Storey Side Extension and Alterations to Existing Garden Room.		
DRAWING TITLE	Proposed Elevations.		
SCALE @ A1	DRAWN BY	SCALE BAR @ 1:50	
1:50		0 1 2 M	
JOB REF.	DRAWING NO.	REV	DATE
SP1151	PL 05	B	July 2014



Awake Architects, 44 Garston Old Road,  
Liverpool, L19 9AF, Tel: 0151 427 5017  
info@awakearchitects.co.uk / www.awakearchitects.co.uk