


clocks walls lined with plywood to comply with criterion 11.

drainage allocation for a shower in the wc area

clear turning space shown hatched.

bathroom walls lined with plywood to comply with criterion 11.

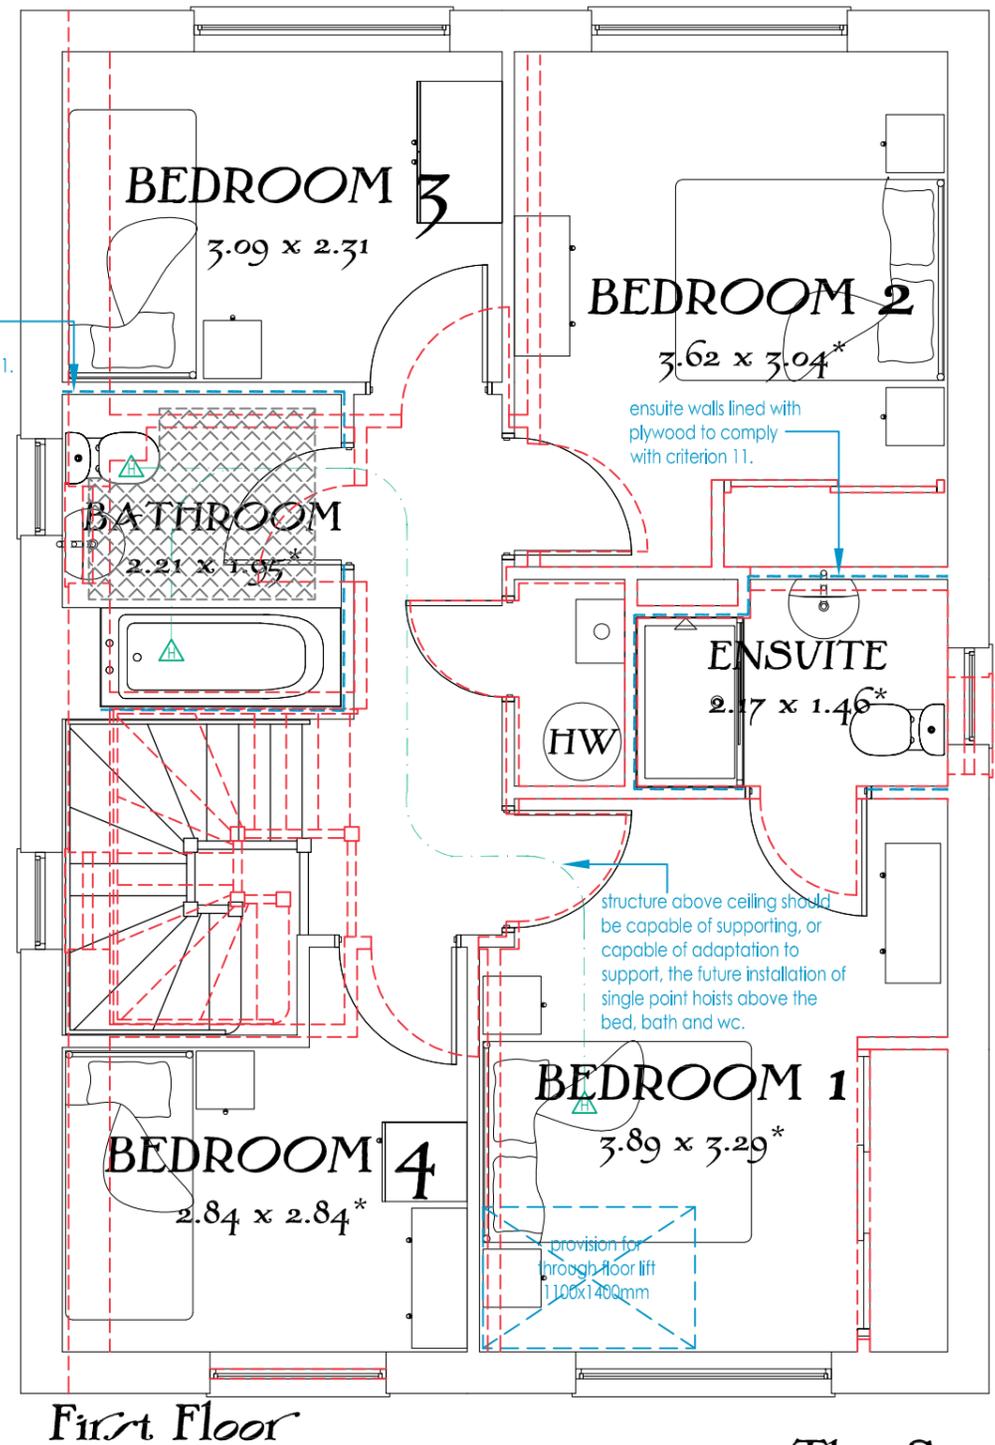

ensuite walls lined with plywood to comply with criterion 11.

- Key:-**
- Location of walls / doors on standard house type shown in red.
 - Extra items required to comply with Lifetime Homes shown in blue.
 - - - ▲ Track Hoist route shown in green.
 - Clear space required in WC & Bathroom.

- General Notes**
- Each habitable room to have 1 No. openable window with controls no higher than 1200mm from finished floor level (kitchen & bathroom window not applicable).
 - All service controls should be within a height of 450mm to 1200mm from finished floor. Services include switches, sockets, tv / telephone points, consumer units, heating programmer / radiator thermostats, and water stop tap.

The Stratford
Lifetime Homes
Based on E4H117-3
1239sqft (1173sqft)

DATE: Aug 2014
Drawing scale 1:50 @ A3