


Ground Floor



First Floor

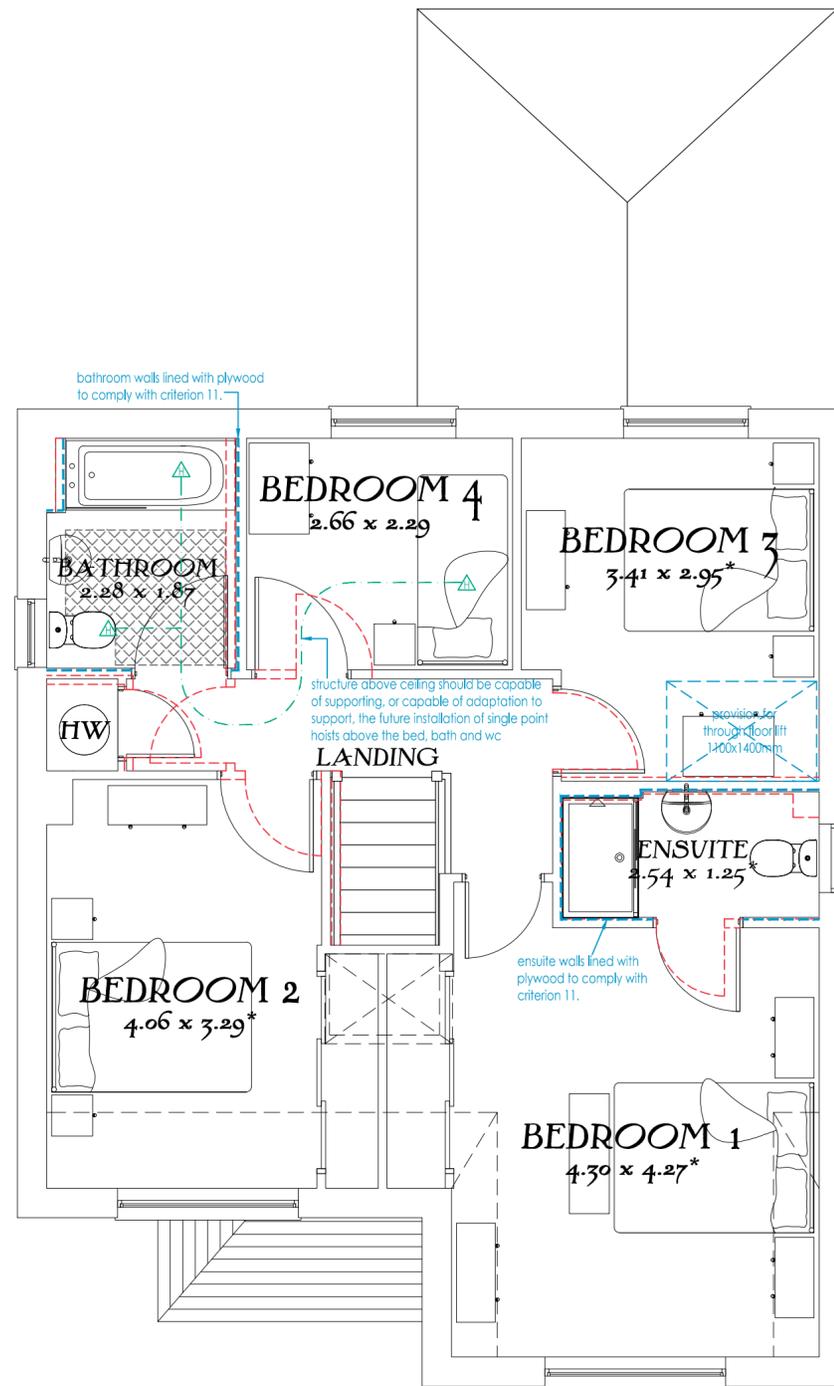

- Key:-**
- Location of walls / doors on standard house type shown in red.
  - Extra items required to comply with Lifetime Homes shown in blue.
  - Track Hoist route shown in green.
  - Clear space required in WC & Bathroom.

- General Notes**
- Each habitable room to have 1 No. openable window with controls no higher than 1200mm from finished floor level (kitchen & bathroom window not applicable).
  - All service controls should be within a height of 450mm to 1200mm from finished floor. Services include switches, sockets, tv / telephone points, consumer units, heating programmer / radiator thermostats, and water stop tap.

The Cambridge  
Lifetime Homes  
Based on E4H138-3

DATE: July 2014  
REV: A

Drawing scale 1:50 @ A2



Revisions:  
A 01.02.16 Conservatory added.