


Ground Floor



First Floor

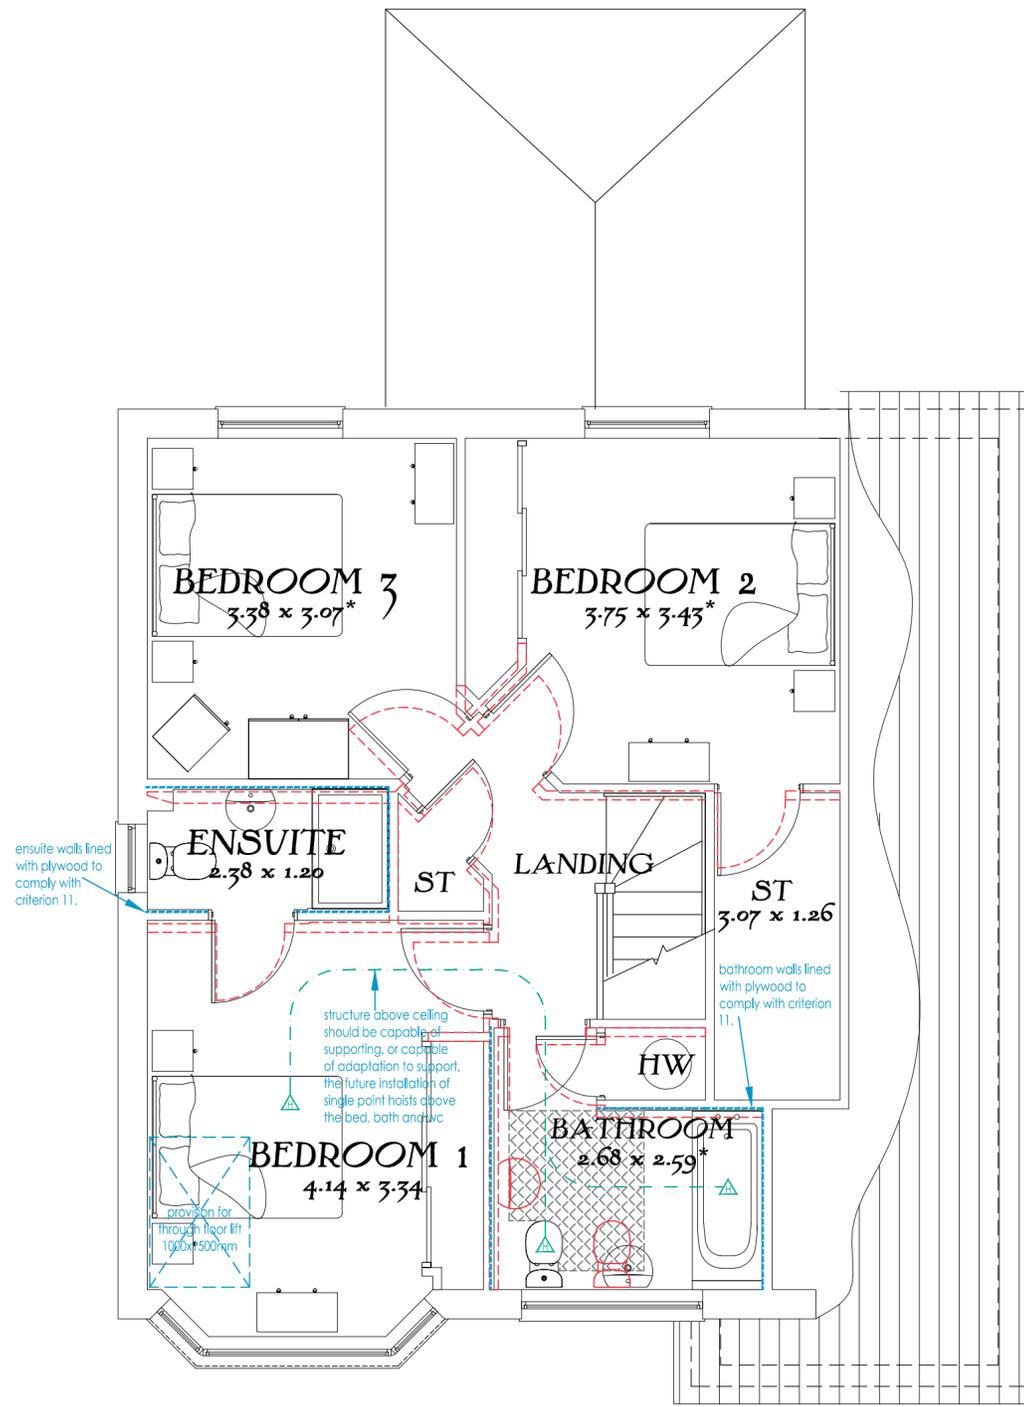

- Key:-**
- Location of walls / doors on standard house type shown in red.
  - Extra items required to comply with Lifetime Homes shown in blue.
  - Track Hoist route shown in green.
  - Clear space required in WC & Bathroom.

- General Notes**
- Each habitable room to have 1 No. openable window with controls no higher than 1200mm from finished floor level (kitchen & bathroom window not applicable).
  - All service controls should be within a height of 450mm to 1200mm from finished floor. Services include switches, sockets, tv / telephone points, consumer units, heating programmer / radiator thermostats, and water stop tap.

The Worcester  
 Lifetime Homes  
 Based on E4H118.1  
 DATE: July 2014  
 REV: A

Drawing scale 1:50 @ A2

Revisions:  
 A 01.02.16 Conservatory added.

