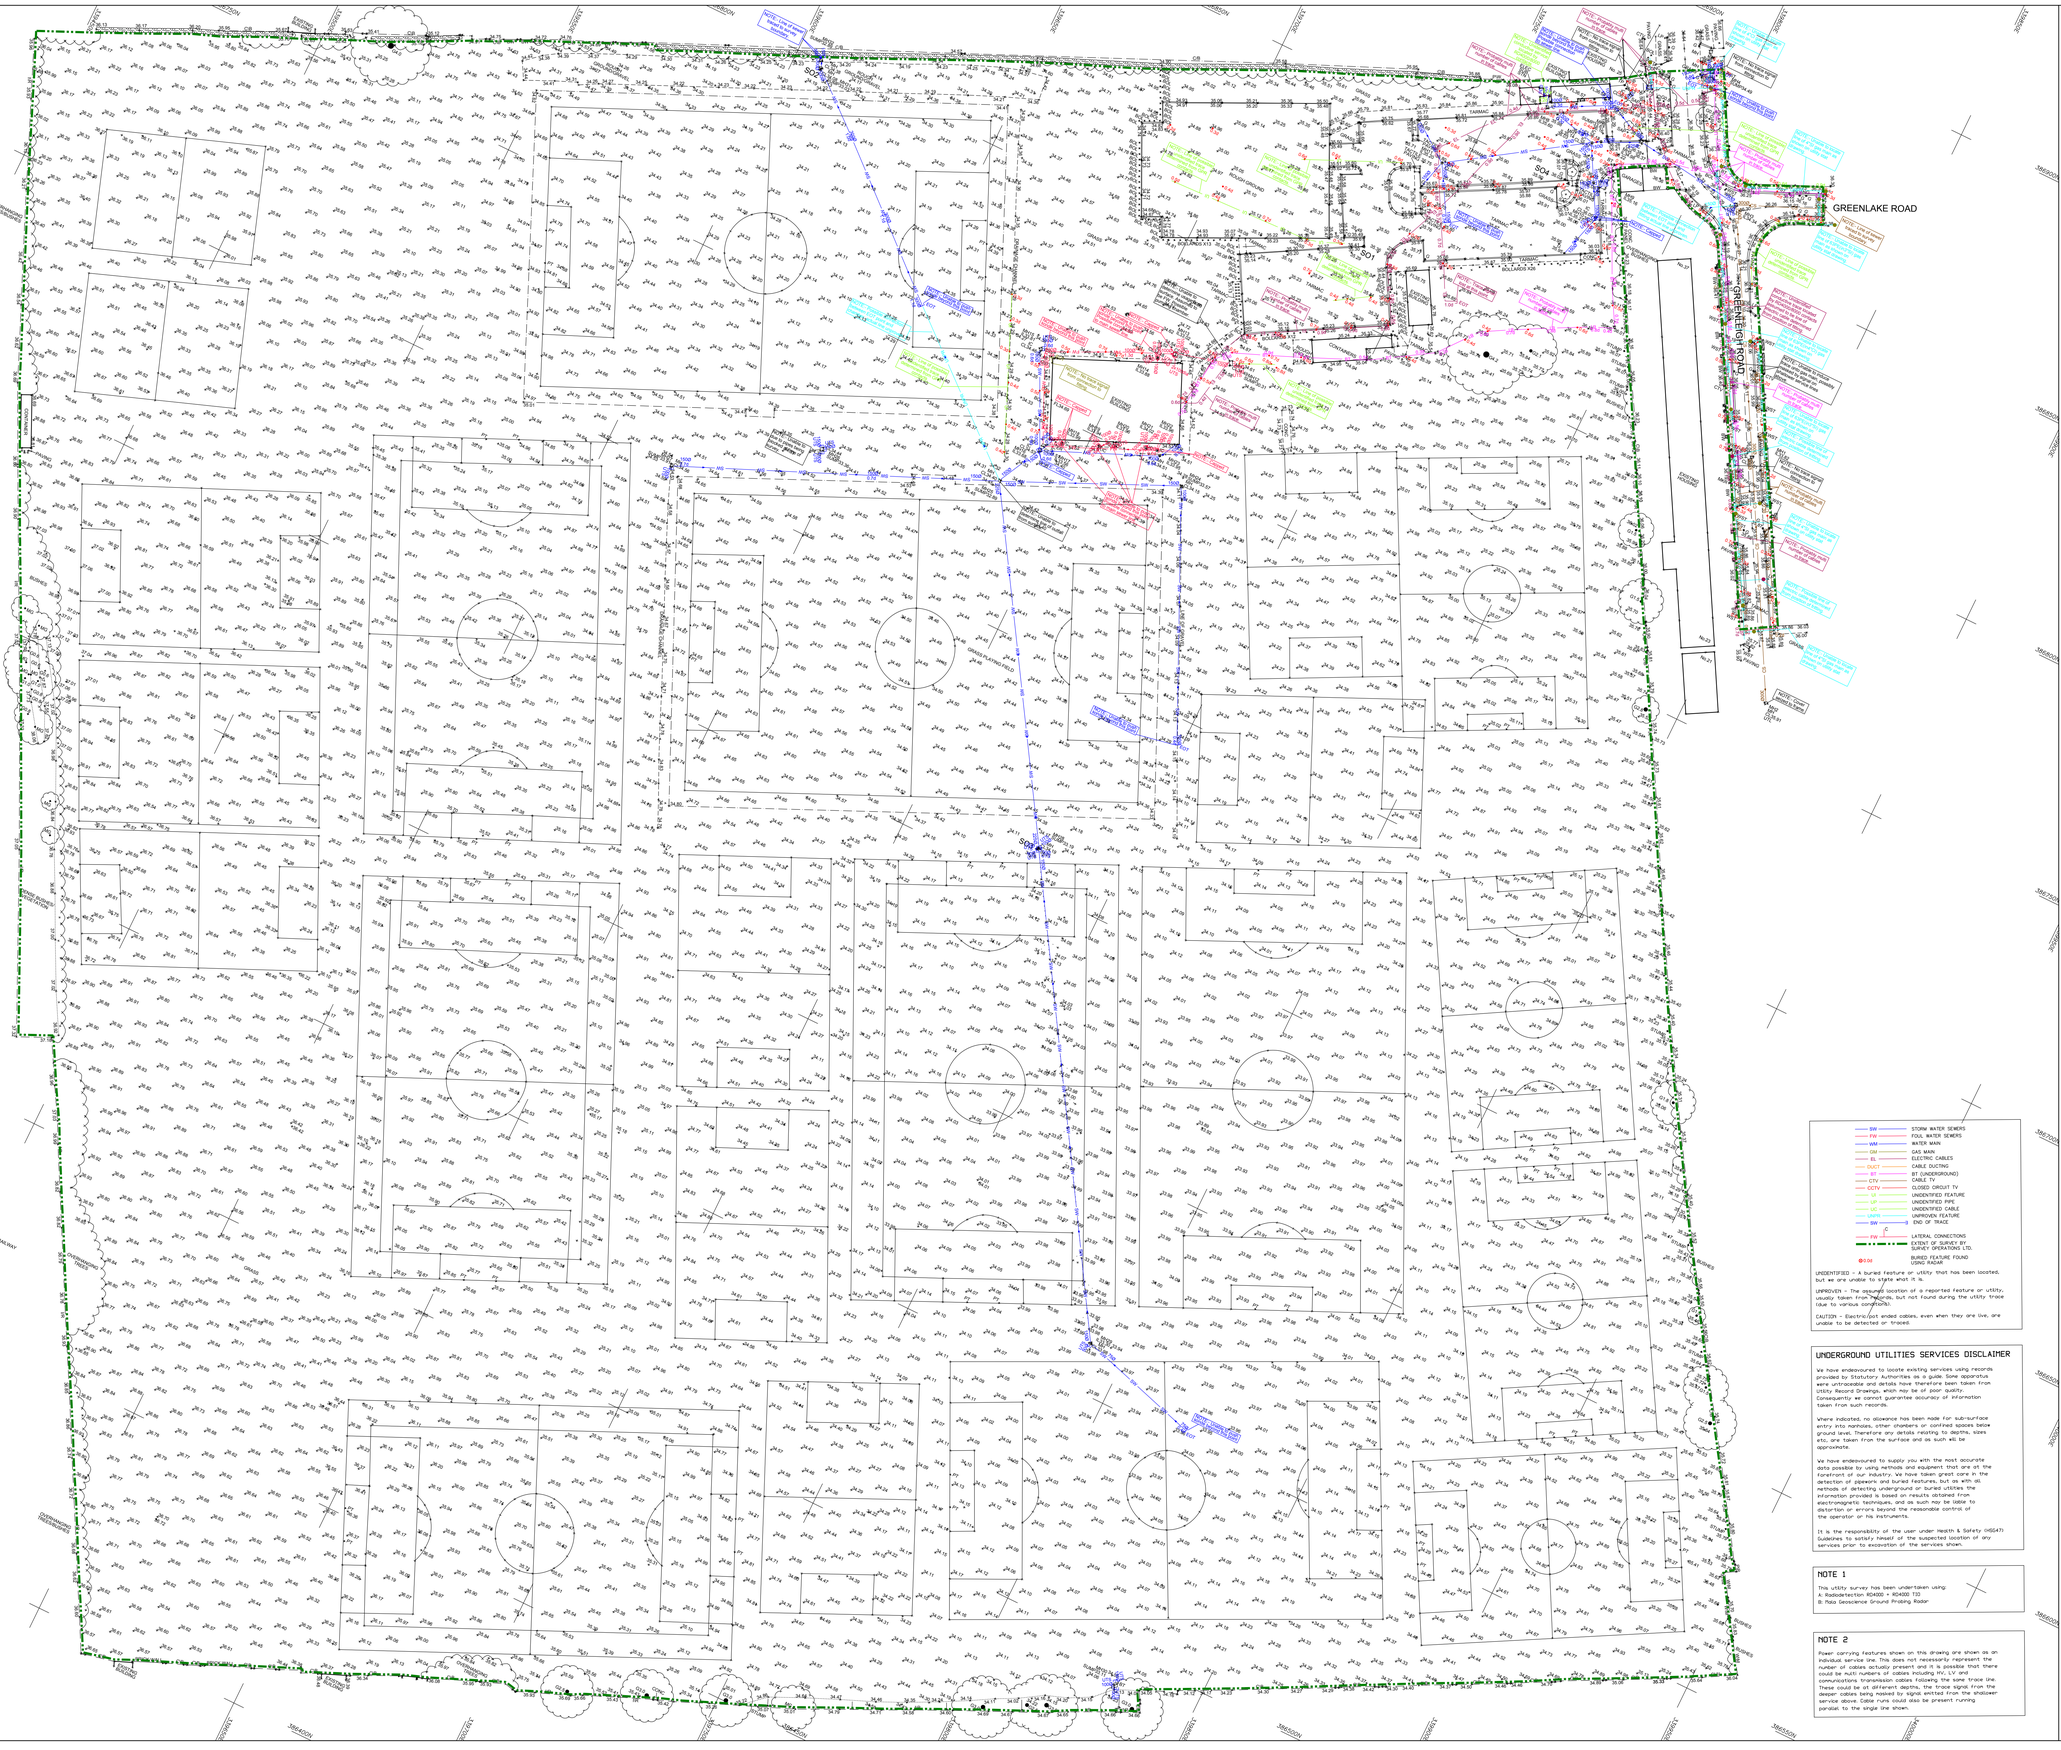

© Survey Operations Limited 2015
Reproduction in whole or in part by any means is prohibited without the prior permission of Survey Operations Limited.

Note:
The survey is plotted on a plane local Grid. Orientation to National Grid.
All levels relate to Ordnance Datum, achieved using the OS National GPS Network.
Survey Control Markers established for Mapping purposes only and should not be used for Construction without the written approval of Survey Operations Ltd.
Utility survey added to topographical survey job number 15J257.
All drainage information must be verified with local authority records before use.

SURVEY STATIONS

Name	Easting	Northing	Height
S01	339737.21	386816.39	35.43
S02	339650.61	386788.15	34.09
S03	339730.34	386658.45	34.19
S04	339773.35	386850.18	36.13

STANDARD REFERENCE & ABBREVIATIONS

(AR).....Assumed Route
AB.....Air Brick
AV.....Air Valve
B/W.....Barbed Wire
BAR.....Barrier
BB.....Belisha Beacon
BH.....Borehole
BL.....Bed Level
BOL.....Bollard
BS.....Bus Stop
BT Box.....British Telecom Box
BT.....Open British Telecom JC
BRTW.....Brick Retaining Wall
BW.....Brick Wall
C/B.....Close Boarded
C/I.....Corrugated Iron
C/P.....Chestnut Paling
CB.....Control Box
CBW.....Concrete Block Wall
CCTV.....Closed Circuit TV
CD.....Cable Duct
CEL.....Cellar Light
CH/L.....Chain Link
CHY.....Chimney
CL.....Cover Level
CM.....Cable Marker
COL.....Column
CONC.....Concrete
CP.....Catch Pit
CRTW.....Concrete Retaining Wall
CTV.....Cable Television
CUL.....Culvert
CW.....Concrete Block Wall
DC.....Drainage Channel
DPC.....Damp Proof Course
DR.....Drain
DSW.....Dry Stone Wall
ECP.....Electricity Cable Pit
EIC.....Electricity Inspection Cover
EJ.....Expansion Joint
ELB.....Electricity Junction Box
EL Sub STN..Electricity Sub Station
EL.....Eaves Level
ELB.....Electricity Box
EP.....Electricity Pole
ER.....Earth Rod
ETL.....Electricity Transmission Line
FB.....Flower Bed
FH.....Fire Hydrant
FL.....Floor Level
FP.....Flagpole
G*.....Girth (of tree)
G.....Gulley
GAB.....Gabion
GIP.....Gas Inlet Pipe
GMWB.....Gas Marker
GOT.....Gas Stop Tap (Domestic)
GRV.....Gas Stop Valve (Mains)
HHZ.....Housing
HT.....Height
HV.....High Voltage
I/R.....Iron Railing
IC.....Inspection Cover
IL.....Invert Level
IP.....Inlet Pipe
KO.....Kerb Outlet
LB.....Letter Box
LP.....Lamp Post
MB.....Multi Birth
MH.....Manhole
MKR.....Marker
MP.....Mooring Point
NP.....Street Name Plate
O/H.....Overhead
O/P.....Open Paling
OE.....Overhead Electric Wire
OF.....Outfall Pipe
OSBM.....Ordnance Survey Bench Mark
OT.....Overhead Telecom Wire
P/C.....Post & Chain
P/R.....Post & Rail
P/W.....Post & Wire
PAV.....Paving
PB.....Pillar Box
PC.....Pedestrian Crossing
PP.....Petrol Pump
PT.....Post or Pillar
RE.....Reading Eye
RS.....Road Sign
RTW.....Retaining Wall
RWP.....Rain Water Pipe
SAP.....Sapling
SL.....Soak Level
SoL.....Soffit Level
SP.....Sign Post
SPL.....Springing Level
SRTW.....Stone Retaining Wall
SV.....Stop Valve (unspecified)
SVP.....Soil Vent Pipe
SW.....Stone Wall
TAR.....Tarmac Paving
TB.....Traffic Bollard
TBM.....Temporary Bench Mark
TCB.....Telephone Call Box
TFR.....Telec Fron Records
TJB.....Another Point (Shafts/Poles)
TL.....Traffic Light
TLB.....Traffic Light Control Box
TM.....Ticket Machine
TNC.....Tarmac
TP.....Telecommunications Pole
TPIT.....Trial Pit
TS.....Trash Screen
U/C.....Under Construction
U/G.....Underground
UTL.....Unable to Lift (MH,SC etc)
UTS.....Unable to Survey
VDP.....Vehicle Detector Pad
VP.....Vent Pipe
W/M.....Wire Mesh
WL.....Water Level
WM.....Water Meter
WO.....Wash Out
WP.....Waste Pipe
WST.....Water Stop Tap (Domestic)
WSV.....Water Stop Valve (mains)

SW ..... STORM WATER SEWERS
FW ..... FOUL WATER SEWERS
WM ..... WATER MAIN
GM ..... GAS MAIN
EL ..... ELECTRIC CABLES
DUCT ..... CABLE DUCTING
BT ..... BT (UNDERGROUND) CABLE TV
CTV ..... CLOSED CIRCUIT TV
UF ..... UNIDENTIFIED FEATURE
UP ..... UNIDENTIFIED PIPE
UC ..... UNIDENTIFIED CABLE
UNPR ..... UNPROVEN FEATURE
DW ..... END OF TRACE
C
FW ..... LATERAL CONNECTIONS
EXTENT OF SURVEY BY SURVEY OPERATIONS LTD.
BURIED FEATURE FOUND USING RADAR

UNIDENTIFIED - A buried feature or utility that has been located, but we are unable to state what it is.

UNPROVEN - The assumed location of a reported feature or utility, usually taken from records, but not found during the utility trace (due to various conditions).

CAUTION - Electric/not ended cables, even when they are live, are unable to be detected or traced.

UNDERGROUND UTILITIES SERVICES DISCLAIMER

We have endeavoured to locate existing services using records provided by Statutory Authorities as a guide. Some apparatus were untraceable and details have therefore been taken from Utility Record Drawings, which may be of poor quality. Consequently we cannot guarantee accuracy of information taken from such records.

Where indicated, no allowance has been made for sub-surface entry into manholes, other chambers or confined spaces below ground level. Therefore any details relating to depths, sizes etc. are taken from the surface and as such will be approximate.

We have endeavoured to supply you with the most accurate data possible by using methods and equipment that are at the forefront of our industry. We have taken great care in the detection of pipework and buried features, but as with all methods of detecting underground or buried utilities the information provided is based on results obtained from electromagnetic techniques, and as such may be liable to distortion or errors beyond the reasonable control of the operator or his instruments.

It is the responsibility of the user under Health & Safety (HSG47) Guidelines to satisfy himself of the suspected location of any services prior to excavation of the services shown.

NOTE 1

This utility survey has been undertaken using:
A: Radiodetection RD4000 + RD4000 TX2
B: Mala Geoscience Ground Probing Radar

NOTE 2

Power carrying features shown on this drawing are shown as an individual service line. This does not necessarily represent the number of cables actually present and it is possible that there could be multi numbers of cables including HV, LV and communications transmission cables following the same trace line. These could be at different depths, the trace signal from the deeper cables being masked by signal emitted from the shallower service above. Cable runs could also be present running parallel to the single line shown.

SurveY OPERATIONS
Smith Street, Skelmersdale, Lancs. WN8 8LN
Tel: 01695 725662 Fax: 01695 51816
Email: mail@survops.co.uk -- www.survops.co.uk

Client
MOUCHEL

Drawing Title
UTILITY SURVEY OF LAND AT
HERON ECCLES SPORTS GROUND
ABBOTSHEY AVENUE

Scale(s)	1:500	Surveyor	TW
Date	Nov 15	Drawn	IT
Job Number	15J258	Checked	TW/SG

Sheet Size & Drg Number & Revision
A0 15J258/001