

**Kier Services
Exchange Station
Tithebarn Street**

**Liverpool
L2 2QP**

FAO:

Dear Sirs

Location: Jericho Lane Playing Fields Jericho Lane Otterspool Liverpool L17

I acknowledge with thanks your request dated 24/11/15 for information on the location of our services.

Please find enclosed plans showing the approximate position of our apparatus known to be in the vicinity of this site. The enclosed plans are being provided to you subject to the United Utilities Terms and Conditions - Wastewater & Water Distribution Plans which are shown overleaf.

I also attach United Utilities' General Condition and Information sheets regarding United Utilities wastewater network and water distribution apparatus, which details contact numbers for additional services (i.e. new supplies, connections, diversions) which we are unable to deal with at this office. You should ensure that the Condition and Information sheets are made available to anyone carrying out any works which may affect our apparatus.

I trust the above meets with your requirements and look forward to hearing from you should you need anything further.

If you have any queries regarding this matter please telephone us on 0370 7510101.

Yours Faithfully,




Sue McManus
Operations Manager
Property Searches

United Utilities Water Limited
Property Searches
Ground Floor Grasmere House
Lingley Mere Business Park
Great Sankey
Warrington
WA5 3LP
DX 715568 Warrington
Telephone 0370 751 0101

Property.searches@uuplc.co.uk

Your Ref: 1070133-JL
Our Ref: 14/ 1159063
Date: 26/11/2015

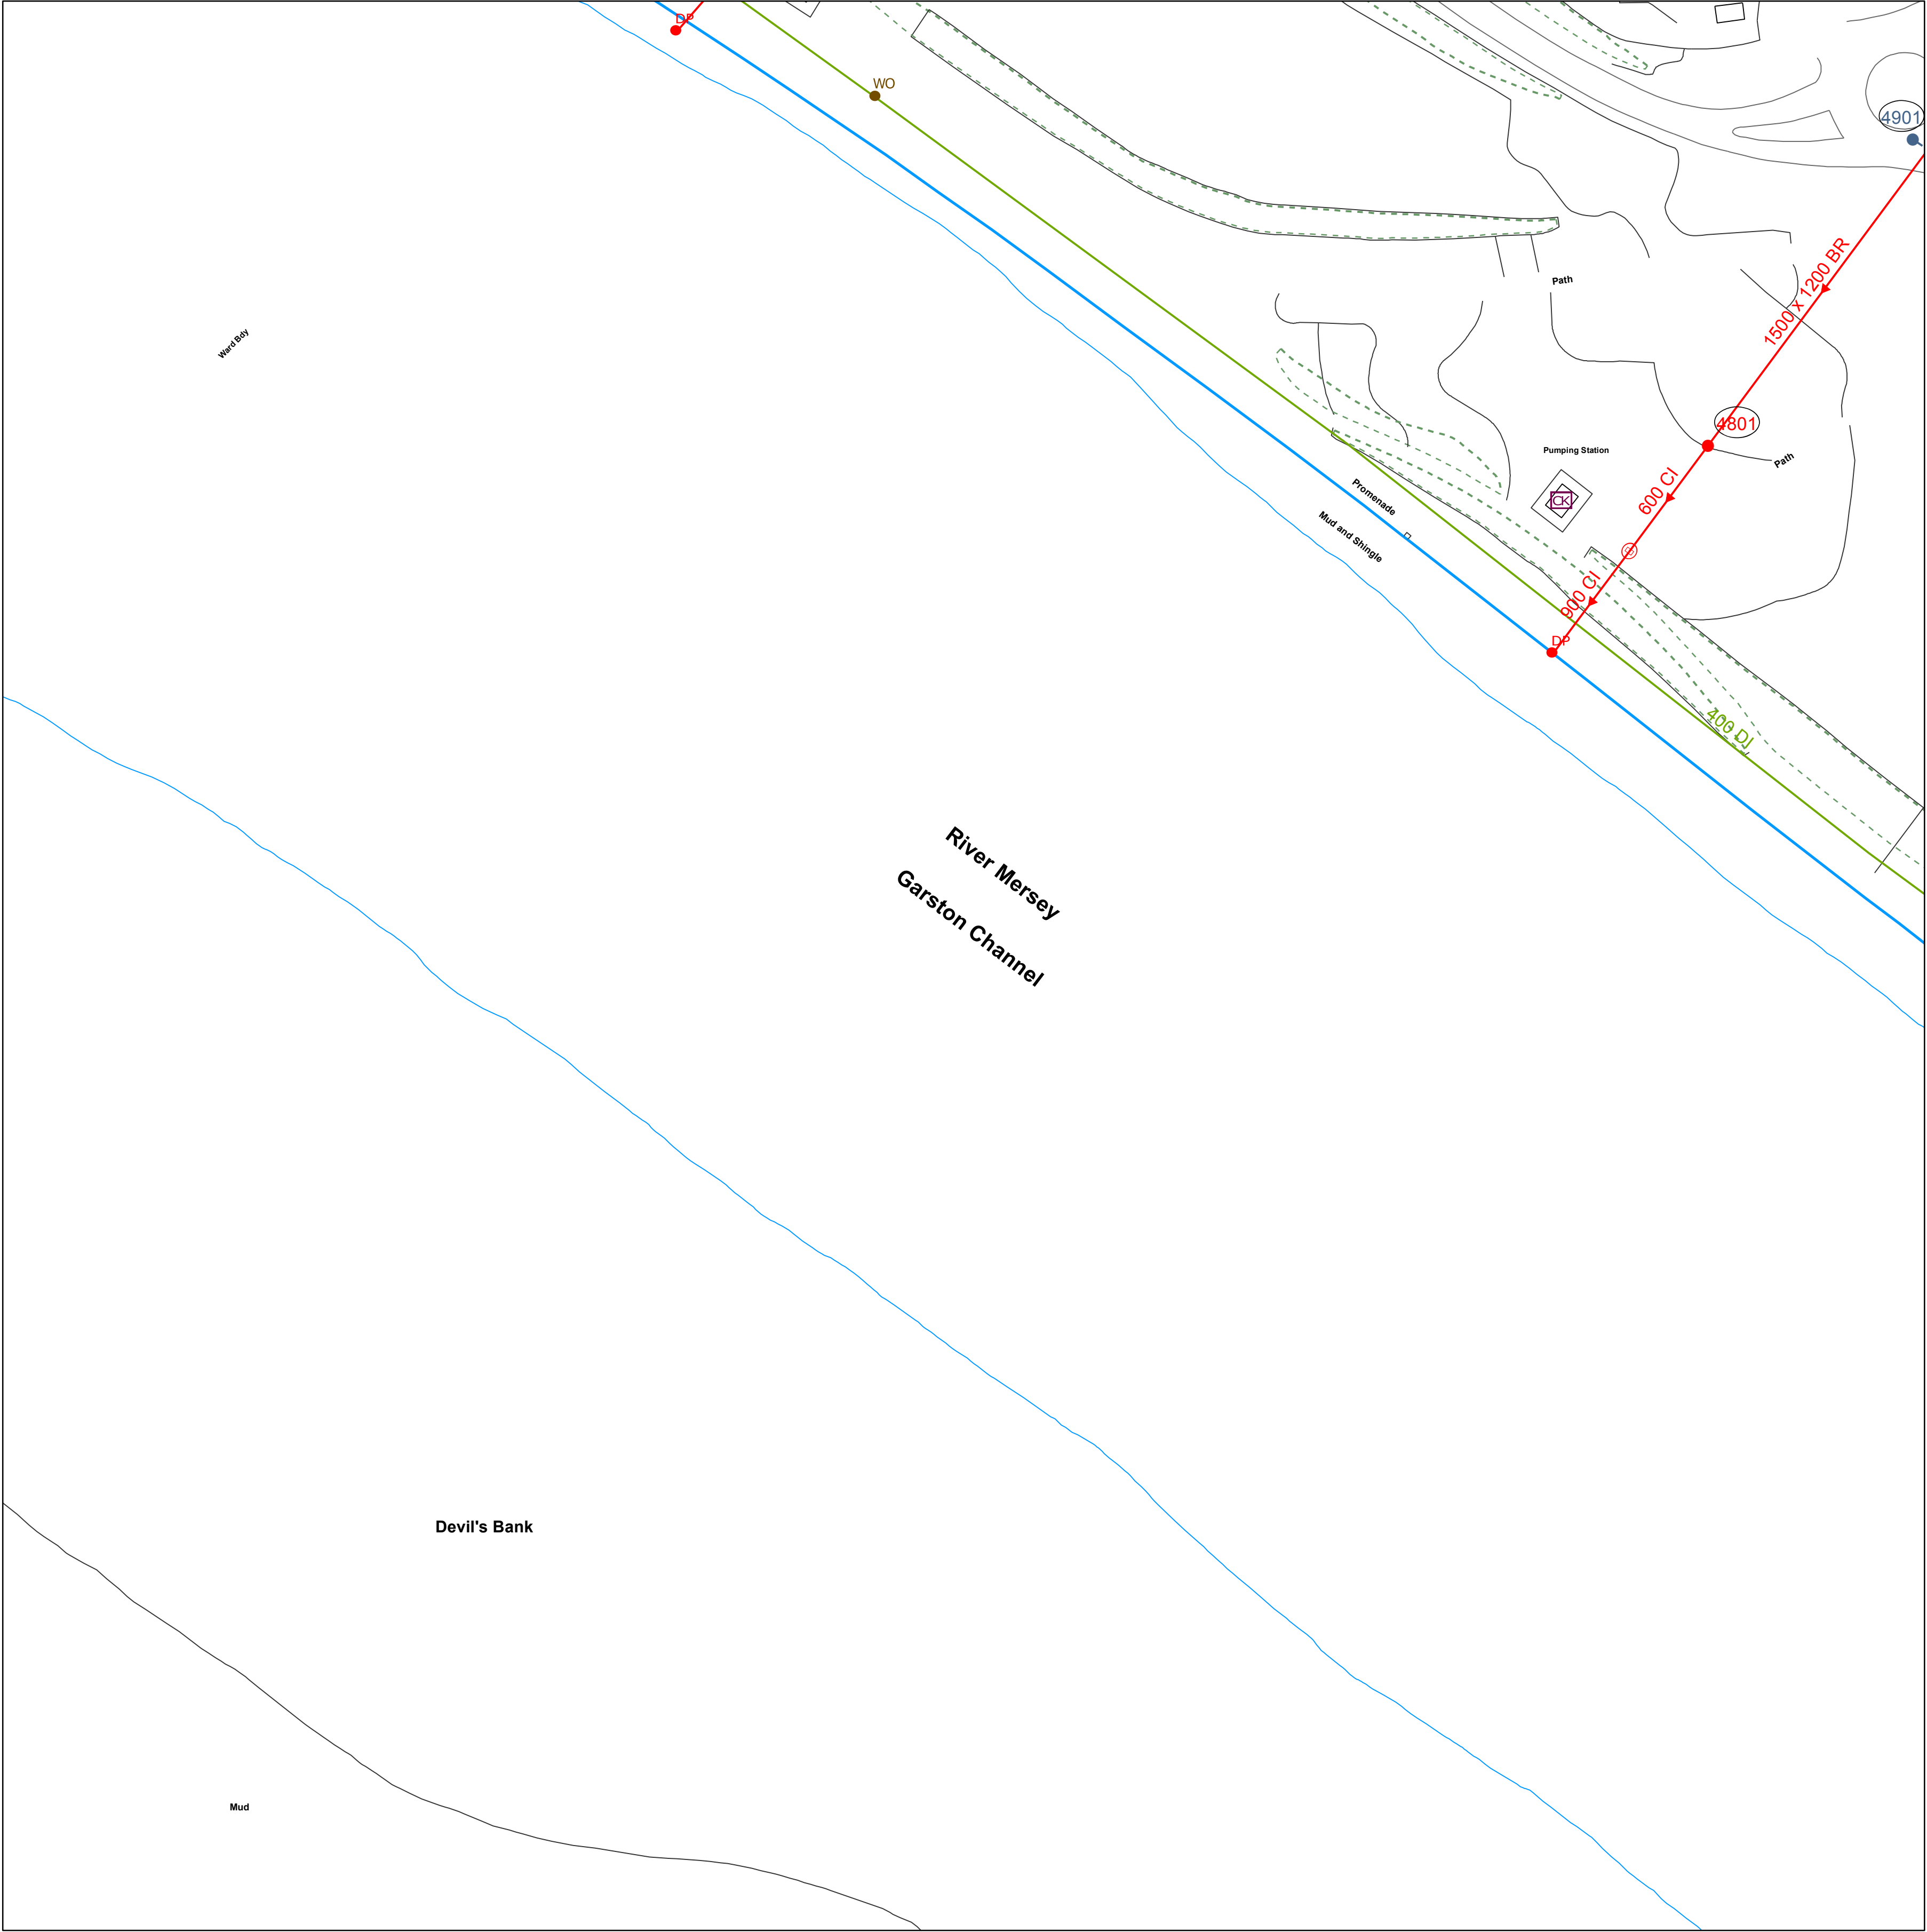

Refno	Cover	Func	Invert	Size	xSize	yShape	Matl	Length	Grad	Refno	Cover	Func	Invert	Size	xSize	yShape	Matl	Length	Grad
4801	10.74	CO																	
4901		SW																	
4804		CO																	

WASTE WATER SYMBOLOLOGY				
Foul	Surface	Combined	Overflow	
				Manhole
				Manhole, Side Entry
				MainSewer, Public
				MainSewer, Private
				MainSewer, S104
				Rising Main, Public
				Rising Main, Private
				Rising Main, S104
				Highway Drain, Private
				WW Site Termination
				Air Valve
				Cascade
				Non Return Valve
				Extent of Survey
				Flow Meter
				Gully
				Hatch Box
				Head of System
				Hydrobrake / Vortex
				Inlet
				Inspection Chamber
				Bifurcation
				Catchpit
				Contaminated Surface Water
				WW Pumping Station
				Sludge Pumping Station
				Sewer Overflow
				T Junction/Saddle
				LampHole
				OilInterceptor
				PenStock
				Pump
				RoddingEye
				Soakaway
				Summit
				Valve
				Valve Chamber
				Washout Chamber
				DropShaft
				WW Treatment Works
				Septic Tank
				Vent Column
				Network Storage Tank
				Orifice Plate
				Vortex Chamber
				Penstock Chamber
				Blind Manhole
				Screen Chamber
				Discharge Point
				Outfall
				Control Kiosk
				Unspecified

LEGEND			
MANHOLE FUNCTION			
FO	Foul		
SW	Surface Water		
CO	Combined		
OV	Overflow		
SEWER SHAPE			
CI	Circular	TR	Trapezoidal
EG	Egg	AR	Arch
OV	Oval	BA	Barrel
FT	Flat Top	HO	HorseShoe
RE	Rectangular	UN	Unspecified
SQ	Square		
SEWER MATERIAL			
AC	Asbestos Cement	DI	Ductile Iron
BR	Brick	PVC	Polyvinyl Chloride
PE	Polyethylene	CI	Cast Iron
RP	Reinforced Plastic Matrix	SI	Spun Iron
CO	Concrete	ST	Steel
CSB	Concrete Segment Bolted	VC	Vitrified Clay
CSU	Concrete Segment Unbolted	PP	Polypropylene
CC	Concrete Box Culverted	PF	Pitch Fibre
PSC	Plastic/Steel Composite	MAC	Masonry, Coursed
GRC	Glass Reinforced Concrete	MAR	Masonry, Random
GRP	Glass Reinforced Plastic	U	Unspecified

The position of underground apparatus shown on this plan is approximate only and is given in accordance with the best information currently available.
The actual positions may be different from those shown on the plan and private pipes, sewers or drains may not be recorded.
United Utilities will not accept any liability for any damage caused by the actual positions being different from those shown.
United Utilities Water Limited 2014. The plan is based upon the Ordnance Survey Map with the sanction of the Controller of H.M. Stationery Office. Crown and United Utilities copyrights are reserved. Unauthorised reproduction will infringe these copyrights.

OS Sheet No: SJ3785NW
Scale: 1: 1250 Date: 26/11/2015
3 Nodes
Sheet 1 of 1




SEWER RECORDS

OS Sheet No: SJ3785NW

Scale: 1: 1250 Date: 26/11/2015

Printed By: Property Searches

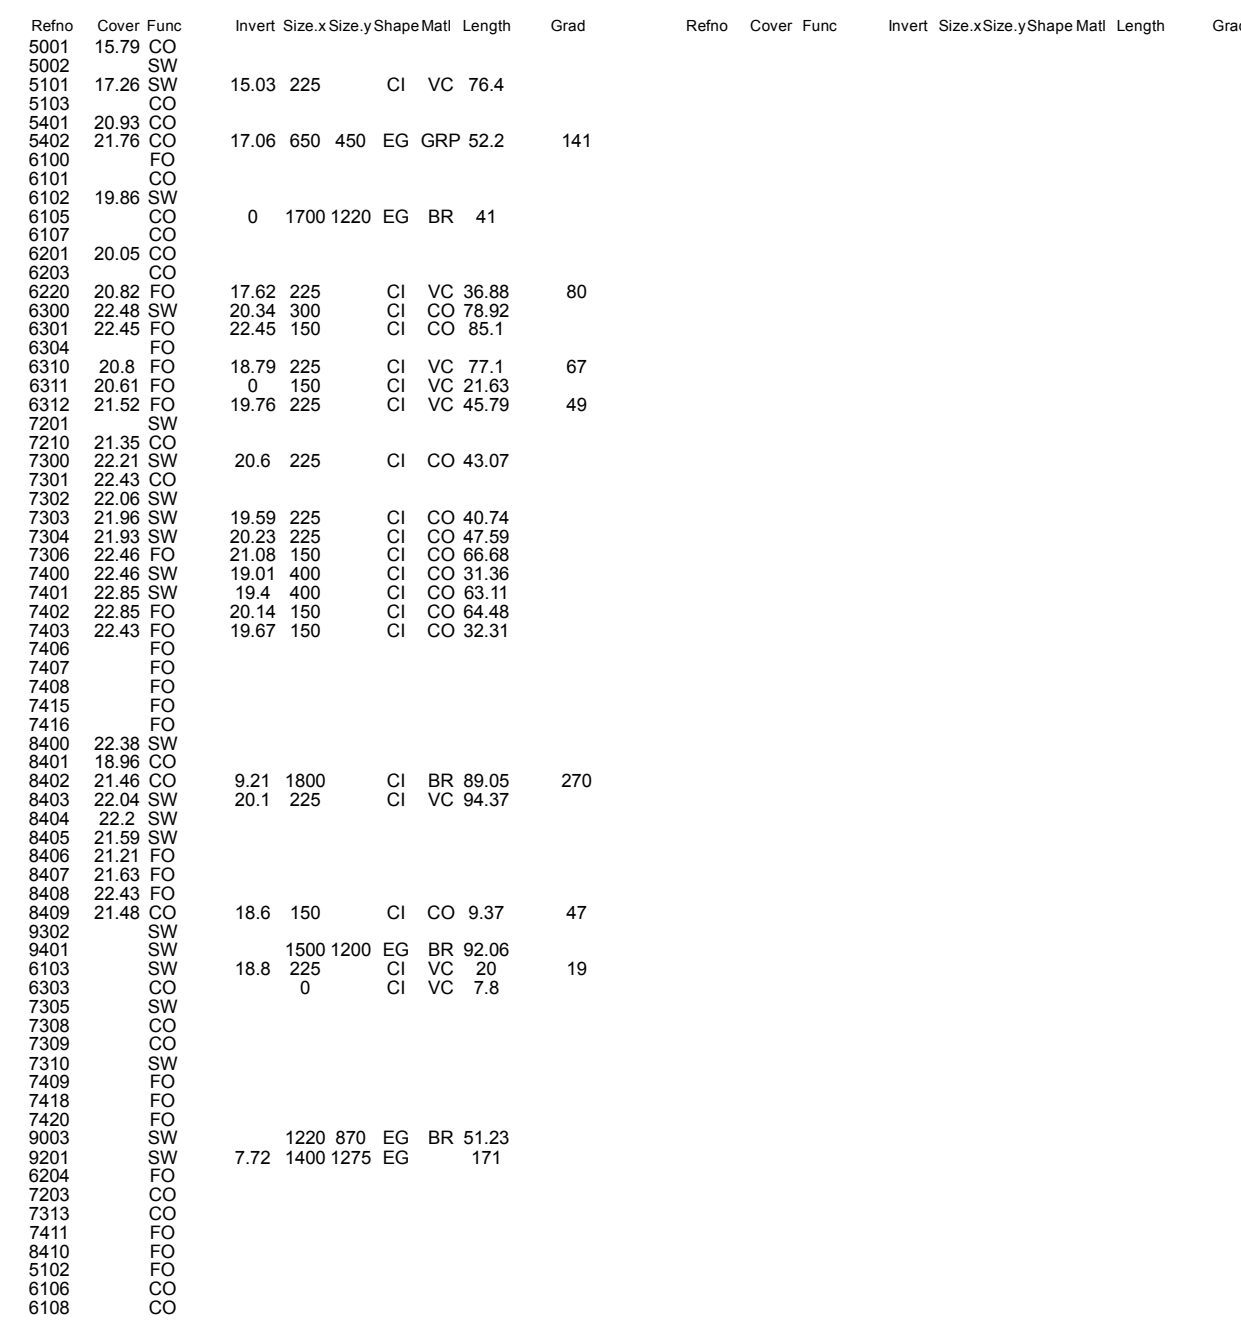

MANHOLE FUNCTION		LEGEND	
FO	Foul		
SW	Surface Water		
CO	Combined		
OV	Overflow		
SEWER SHAPE			
CI	Circular	TR	Trapezoidal
EG	Egg	AR	Arch
OV	Oval	BA	Barrel
FT	Flat Top	HO	HorseShoe
RE	Rectangular	UN	Unspecified
SO	Square		
SEWER MATERIAL			
AC	Asbestos Cement	DI	Ductile Iron
BR	Brick	PVC	Polyvinyl Chloride
PI	Polyethylene	CI	Cast Iron
RP	Reinforced Plastic Matrix	SI	Spun Iron
CO	Concrete	ST	Steel
CSB	Concrete Segment Bolted	VC	Vitrified Clay
CSU	Concrete Segment Unbolted	PP	Polypropylene
CC	Concrete Box Culverted	PF	Pitch Fibre
PSC	Plastic/Steel Composite	MAC	Masonry, Coursed
GRC	Glass Reinforced Concrete	MAR	Masonry, Random
GRP	Glass Reinforced Plastic	U	Unspecified

the position of underground apparatus shown on this plan is approximate only and is given in accordance with the best information currently available.

It is acknowledged that the actual positions may be different from those shown on the plan and private pipes, sewers or drains may not be recorded.

United Utilities will not accept any liability for any damage caused by the actual positions being different from those shown.

This plan is dated 1st January 2014. The plan is based upon the Ordnance Survey Map with the permission of the Controller of H.M. Stationery Office. Crown and United Utilities copyrights are reserved. Unauthorised reproduction will infringe these copyrights.

OS Sheet No: SJ3786SE
Scale: 1: 1250 Date: 26/11/2015
68 Nodes
Sheet 1 of 1



SEWER RECORDS

Scale: 1: 1250 Date: 26/11/2015

Printed By: Property Searches

OS Sheet No: SJ3786SW

Scale: 1: 1250 Date: 26/11/2015

Printed By: Property Searches

WASTE WATER SYMOLOGY

Foul	Surface	Combined	Overflow	
				Manhole
				Manhole, Side Entry
				Mainsewer, Public
				Mainsewer, Private
				Mainsewer, S104
				Rising Main, Public
				Rising Main, Private
				Rising Main, S104
				Highway Drain, Private

Foul	Surface	Combined	
			WW Site Termination
			Air Valve
			Cascade
			Non Return Valve
			Extent of Survey
			Flow Meter
			Gully
			Hatch Box
			Head of System
			Hydrobrake / Vortex
			Inlet
			Inspection Chamber
			Bifurcation
			Catchpit
			Contaminated Surface Water
			WW Pumping Station
			Sludge Pumping Station
			Sewer Overflow
			T Junction/Saddle
			LampHole
			Oil Interceptor
			PenStock
			Pump
			RoddingEye
			Soakaway
			Summit
			Valve
			Valve Chamber
			Washout Chamber
			DropShaft
			WW Treatment Works
			Septic Tank
			Vent Column
			Network Storage Tank
			Orifice Plate
			Vortex Chamber
			Penstock Chamber
			Blind Manhole

Foul	Surface	Combined	
			Screen Chamber
			Discharge Point
			Outfall

ABANDONED PIPE

Main Sewer

Rising Main

Highway Drain

Sludge Main

Control Kiosk

Unspecified

LEGEND

MANHOLE FUNCTION

FO	Foul
SW	Surface Water
CO	Combined
OV	Overflow

SEWER SHAPE

CI	Circular	TR	Trapezoidal
EG	Egg	AR	Arch
OV	Oval	BA	Barrel
FT	Flat Top	HO	HorseShoe
RE	Rectangular	UN	Unspecified
SQ	Square		

SEWER MATERIAL

AC	Asbestos Cement	DI	Ductile Iron
BR	Brick	PVC	Polyvinyl Chloride
PE	Polyethylene	CI	Cast Iron
RP	Reinforced Plastic Matrix	SI	Spun Iron
CO	Concrete	ST	Steel
CSB	Concrete Segment Bolted	VC	Vertified Clay
CSU	Concrete Segment Unbolted	PP	Polypropylene
CC	Concrete Box Culverts	PF	Pitch Fibre
PSC	Plastic/Steel Composite	MAC	Masonry, Coursed
GR	Glass Reinforced Concrete	MAR	Masonry, Random
GRP	Glass Reinforced Plastic	U	Unspecified

The position of underground apparatus shown on this plan is approximate only and is given in accordance with the best information currently available.

The actual positions may be different from those shown on the plan and private pipes, sewers or drains may not be recorded.

United Utilities Water Limited 2014. The plan is based upon the Ordnance Survey Map with the sanction of the Controller of H.M. Stationery Office. Crown and United Utilities copyrights are reserved. Unauthorised reproduction will infringe these copyrights.

OS Sheet No: SJ3786SW

Scale: 1: 1250 Date: 26/11/2015

118 Nodes
Sheet 1 of 1



**United
Utilities**
helping life flow smoothly

SEWER RECORDS

Conditions and Information regarding wastewater network

These general conditions and precautions apply to the wastewater network of United Utilities

Please ensure that a copy of these conditions is passed to your representative and contractor on site.

1 United Utilities provides the approximate locations of its sewers according to its records. These records are not necessarily accurate or complete nor do they normally show the positions of every sewer culvert or drain, private connections from properties to the public sewers or the particulars of any private system. No person or company shall be relieved from liability for any damage caused by reason of the actual positions and/or depths being different from those indicated. The records do indicate the position of the nearest known public sewer from which the likely length of private connections can be estimated together with the need for any off site drainage rights or easements.

2 Special requirements relative to our sewers may be indicated. United Utilities employees or its contractors will visit any site at reasonable notice to assist in the location of its underground sewers and advise any precautions that may be required to obviate any damage. To arrange a visit or for further information regarding new supplies, connections, diversions, costing, or any notification required under these General Conditions, please call us on **0345 602 0406**.

3 Where public sewers are within a site which is to be developed and do not take any drainage from outside the area, they are from an operational viewpoint redundant. The developer must identify all redundant sewers affected by the development and apply to United Utilities in writing for these sewers to be formally closed. The developer shall bear all related costs of the physical abandonment work.

4 Public sewers within the site that are still live outside the area will be subject to a "Restricted Building zone". This would normally be a surface area equivalent to the depth of the sewer measured from the centre line of the sewer on either side. No construction will be permitted within that zone. The developer should also note that deep and wide rooted trees must not be planted in close proximity to live sewers. Access to public sewers must be maintained at all times and no interference to manholes will be permitted during construction work.

5. Where there is a public sewer along the line of a proposed development/building, arrangements shall be made by the developer at his cost to divert the sewer around the development. Where this is not possible and as a last resort, a "Building Over Agreement" will need to be completed under section 18 of the Building Act 1984. The developer shall design building foundations to ensure that no additional loading is transferred to the sewer and submit such details both to the Local Authority's Building Control Officer and to United Utilities for approval/acceptance. United Utilities on a rechargeable basis would normally undertake all aspects of design work associated with the diversion of any part of the operational wastewater network. For further advice please email wastewaterdeveloperservices@uuplc.co.uk
6. Where there is a non-main river watercourse/culvert passing through the site, the landowner has the responsibility of a riparian owner for the watercourse/culvert and is responsible for the maintenance of the fabric of the culvert and for all works involved in maintaining the unrestricted flow through it. Building over the watercourse/culvert is not recommended. The developer must contact the local authority before any works are carried out on the watercourse/culvert. Where it is necessary to discharge surface water from the site into the watercourse/culvert the developer shall make an assessment of the available capacity of the watercourse/culvert (based on a 1 in 50 year event) and ensure that the additional flow to be discharged into the watercourse/culvert will not cause any flooding. In appropriate cases, flooding may be prevented by on-site storage. The developer shall submit the relevant details required to substantiate his development proposals. Details of any outfall proposed shall also be submitted to the Environment Agency, PO Box 12, Richard Fairclough House, Knutsford Road, Warrington, Cheshire, WA4 1HT for their approval.
7. Where there is a main river watercourse/culvert passing through the site, the developer shall submit all proposals affecting the river to the Environment Agency at the address stated in paragraph 6 for approval/acceptance.

8. Your attention is drawn also to the following:

Private drains or sewers which may be within the site.

On 1 October 2011 all privately owned sewers and lateral drains which communicate with (that is drain to) an existing public sewer as at 1 July 2011 will become the responsibility of the sewerage undertaker. This includes private sewers upstream of pumping stations that have yet to transfer, but excludes lengths of sewer or drain that are the subject of an on-going appeal or which have been excluded from transfer as a result of an appeal or which are on or under land opted-out by a Crown body. The transfer specifically excludes sewers and lateral drains owned by a railway undertaker. Sewers upstream of such assets, however, are transferred. Such assets may not be recorded on the public sewer record currently as it was not a requirement to keep records of previously private sewers and drains.

Applications to make connections to the public sewer.

The developer must write to United Utilities requesting an application form that must be duly completed and returned. No works on the public sewer shall be carried out until a letter of consent is received from United Utilities.

Sewers for adoption If an agreement for the adoption of sewers under Section 104 of the Water Industry Act 1991 is being contemplated, a submission in accordance with "Sewers for Adoption", Seventh Edition, published by the Water Research Centre (2001) Plc, Henley Road, Medmenham, PO Box 16, Marlow, Buckinghamshire, SL7 2HD will be required, taking into consideration any departures from the general guide stipulated by United Utilities.

Further consultation with United Utilities.

Developers wishing to seek advice or clarification regarding sewer record information provided should contact United Utilities to arrange an appointment. A consultation fee may be charged, details of which will be made available at the time of making an appointment.

9. Combined sewers, foul sewers, surface water sewers, and pumped mains. These are shown separately in a range of colours or markings to distinguish them on our drawings, which are extracts from the statutory regional sewer map. A legend and key is provided on each extract for general use, although not all types of sewer will be shown on every extract.

Combined sewers shown coloured red carries both surface water and foul sewage, especially in areas where there is no separate surface water sewerage system.

Foul sewers coloured brown may also carry surface water and there may be no separate surface water system indicated in the immediate area. Both combined and foul sewers carry wastewater to our treatment works before it can safely be returned to the environment.

Surface water sewers coloured blue on our drawings are intended only to carry uncontaminated surface water (e.g. rainfall from roofs, etc) and they usually discharge into local watercourses. It is important for the protection of the environment and water quality that only uncontaminated surface water is connected to the surface water sewers. Improper connections to surface water sewers from sink wastes, washing machines and other domestic use of water can cause significant pollution of watercourses.

Pumped mains, rising mains and sludge mains will all be subject to pumping pressures and are neither suitable nor available for making new connections.

Highway drains, when included, show as blue and black dashed lines. Highway drains are not assets belonging to United Utilities and are the responsibility of local authorities.

1. For information regarding future proposals for construction of company apparatus please write to United Utilities, PO Box 453, Warrington, WA5 3QN.
2. For information regarding easements, deeds, grants or wayleaves please write to United Utilities Property Solutions, Coniston Buildings, Lingley Mere Business Park, Lingley Green Avenue, Great Sankey, Warrington, WA5 3UU
Tel: 01925 731 365

Conditions and Information regarding water distribution apparatus

These general conditions and precautions apply to the water distribution system of United Utilities

Please ensure that a copy of these conditions is passed to your representative and contractor on site.

1. United Utilities provides approximate locations of its water mains or apparatus according to its records. These records are not necessarily accurate or complete nor do they normally show the positions of private service pipes from the mains to properties. Where service pipes are shown, a blue broken line indicates their approximate position. No person or company shall be relieved from liability for any damage caused by reason of the actual positions and/or depths being different from those indicated.
2. Special requirements relative to our apparatus may be indicated. United Utilities employees will visit any site at reasonable notice to assist in the location of its underground water apparatus and advise any precautions that may be required to obviate any damage. To arrange a visit or for further information regarding new supplies, connections, diversions, costing, future proposals for construction of company apparatus or any notification required under these General Conditions, please telephone us on **0345 746 2200** or write to United Utilities, PO Box 453, Warrington, WA5 3QN.
3. In order to achieve safe working conditions adjacent to any water apparatus the following should be observed;
 - (a) All water apparatus should be located by hand digging prior to the use of mechanical excavation.
 - (b) During construction work where heavy plant may have to cross the line of a water main, and the main is not under a carriageway of adequate standard of construction, crossing points should be suitably reinforced with sleepers, steel plates or a specially constructed reinforced concrete raft as necessary. These crossing points should be clearly indicated and crossing the line of the water main at other places should be prevented. United Utilities employees will advise on the type of reinforcement necessary. This is particularly important on agricultural or open land, where tilling or erosion may have significantly reduced the original cover.

(c) No explosive should be used within 32 metres of any United Utilities apparatus without prior consultation with United Utilities.

(d) Where it is proposed to carry out piling within 15 metres of any water main United Utilities should be consulted so that the affected main may be surveyed.

4. During any excavation, it is important that measures should be taken to ensure continued support for any water main:

(a) Where excavation of trenches adjacent to any water main is likely to affect its support, the main must be supported to the satisfaction of United Utilities.

(b) Where a trench is excavated crossing or parallel to the line of a water main, the backfill should be adequately compacted to prevent any settlement which could subsequently cause damage to the main. In special cases it may be necessary to provide permanent support to a main which has been exposed over the length of the excavation before back-filling and reinstatement is carried out. No back-filled concrete should contact the main.

5. No other apparatus should be laid over and along the line of a water main irrespective of clearance. A minimum clearance of 450 millimetres should be allowed between any plant being installed and an existing main, to facilitate maintenance and repair, whether the adjacent plant is parallel to or crossing the main. No manhole, chamber, or other obstruction should be built over or around a water main.

6. Where a water main is coated with special wrapping and the wrapping is damaged, even to a minor extent, United Utilities must be notified, and the excavation must be left open for ready access so that repairs can be made. In case of any material damage to the main itself causing leakage, or weakening of the mechanical strength of the pipe, the person or body responsible should immediately notify United Utilities in order that the necessary remedial work can be carried out. The full cost of the necessary remedial work will be charged to the person or body responsible for the damage.

1. If you propose to change existing levels over water mains you will need to inform us. We will need specific locations to be identified together with precise details as to the scale of the proposed changes to existing ground levels. Changes to existing levels may require the diversion of our apparatus at your cost. However, in certain circumstances we may wish to leave our apparatus where it is. On these occasions you will usually be required to protect our apparatus by means of a concrete raft and either raise or lower any surface boxes affected.
2. Under no circumstances should our surface boxes be either buried or left in a situation where they are raised above finished ground levels. You should reuse and re-set any surface boxes affected by your works into the new surface so that they align over the water apparatus below. You will be responsible for the cost of repairing any damage to our apparatus as a result of your works.
3. Where proposals involve resurfacing, you must notify United Utilities if your excavation will be greater than 750mm in the highway and 300mm in a footpath, verge or other location.
4. For information regarding easements, deeds, grants, licences or wayleaves, please write to United Utilities Property Solutions, Coniston Buildings, Lingley Mere Business Park, Lingley Green Avenue, Great Sankey, Warrington WA5 3UU (Tel 01925 731 365).

Tree planting restrictions over water mains

a) Poplar and willow trees have extensive root systems and should not be planted within 10 metres of any water main.

b) The following trees and those of a similar size, whether they are deciduous or evergreen, should not be planted within six metres of any water main:

- Ash, beech, birch, elm, horse chestnut, lime, oak, sycamore;
- Apple trees and pear trees;
- Most conifers.



c) United Utilities requires access to the route of its mains at all times to inspect for leaks and carry out surveys. We recommend that no shrubs or bushes which might obstruct or interfere with our access should be planted within one metre of the centre line of any water main.

d) There may be instances when both United Utilities and the landowner will wish to plant shrubs or bushes close to the water main for screening or other purposes. The following shallow rooting shrubs would be suitable for this purpose:

- Blackthorn, broom, cotoneaster, elder;
- Hazel, laurel, privet, quickthorn, snowberry;
- Most ornamental flowering shrubs.

e) In areas where soft fruit is grown, blackcurrant, raspberries and gooseberries may be planted close to the main, provided that a path is left clear for inspection access and surveys. United Utilities can give additional advice where required in particular circumstances.

WASTE WATER SYMBOLOGY

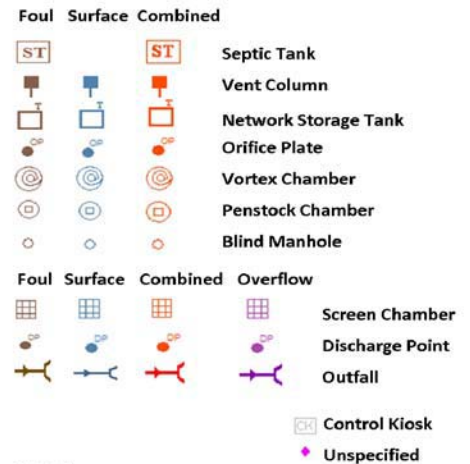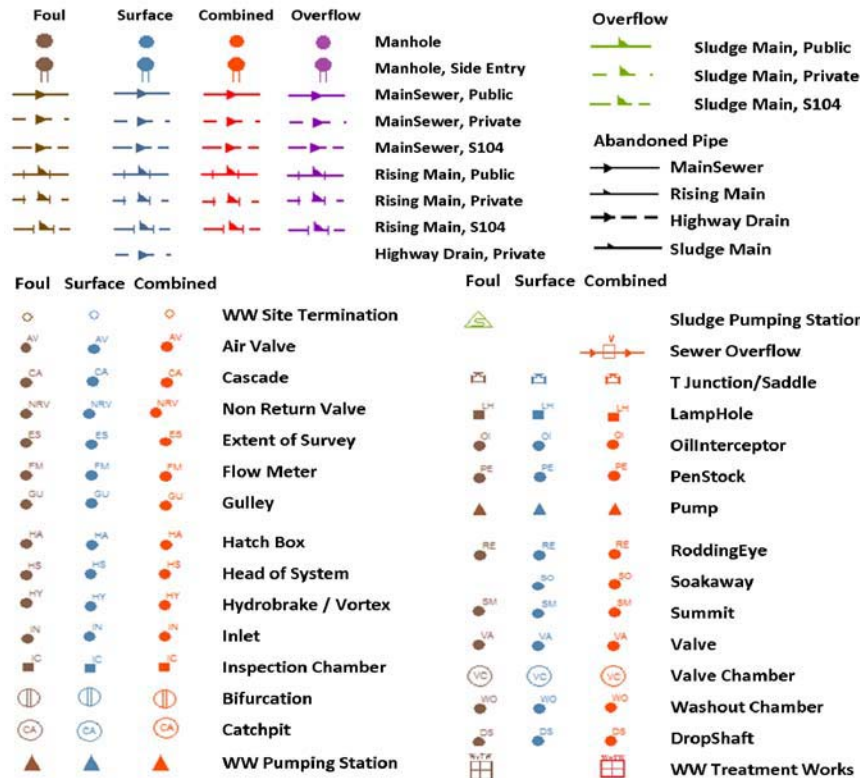

Legend			
MANHOLE FUNCTION		SEWER SHAPE	
FO	Foul	CI	Circular
SW	Surface Water	EO	Egg
CO	Combined	OV	Oval
OV	Overflow	FT	Flat Top
		RE	Rectangular
		SQ	Square
		TR	Trapezoidal
		AR	Arch
		BA	Barrel
		HO	HorseShoe
		UN	Unspecified
SEWER MATERIAL			
AC	Asbestos Cement	DI	Ductile Iron
BR	Brick	VC	Vitrified Clay
CO	Concrete	PP	Polypropylene
CSB	Concrete Segment	PF	Pitched Fibre
CSU	Concrete Segment	MA	Masonry, Coursed
CC	Concrete Box Culverted	MA	Masonry, Random
PSC	Plastic / Steel	RP	Reinforced Plastic
GR	Glass Reinforced	CI	Cast Iron
GRP	Glass Reinforced	SI	Spun Iron
PVC	Polyvinyl Chloride	ST	Steel
PE	Polyethylene	U	Unspecified

CLEAN WATER SYMBOLOGY

PIPE WORK



ABANDONED PIPE



PROPERTY TYPES



NODES/FURNITURES



Legend	
MATERIAL TYPES	LINING TYPES
AC	ASBESTOS CEMENT
CI	CAST IRON
CU	COPPER
CO	CONCRETE
DI	DUCTILE IRON
GI	GALVANISED IRON
GR	GREY IRON
OT	OTHERS
PB	LEAD
PV	UPVC
SI	SPUN IRON
ST	STEEL
UN	UNKNOWN
PE	POLYETHYLENE
CL	CEMENT LINING
TB	TAR OR BITUMEN
ERL	EPOXY RESIN
INSERTION TYPES	
DD	DIE DRAWN
DR	DIRECTIONAL DRILLING
MO	MOLING
PI	PIPELINE
SL	SLIP LINED

TERMS AND CONDITIONS - WASTERWATER & WATER DISTRIBUTION PLANS

These provisions apply to the public sewerage, water distribution and telemetry systems (including sewers which are the subject of an agreement under Section 104 of the Water Industry Act 1991 and mains installed in accordance with the agreement for the self construction of water mains) (UUWL apparatus) of United Utilities Water Limited "(UUWL)".

TERMS AND CONDITIONS:

1. This Map and any information supplied with it is issued subject to the provisions contained below, to the exclusion of all others and no party relies upon any representation, warranty, collateral contract or other assurance of any person (whether party to this agreement or not) that is not set out in this agreement or the documents referred to in it.
2. This Map and any information supplied with it is provided for general guidance only and no representation, undertaking or warranty as to its accuracy, completeness or being up to date is given or implied.
3. In particular, the position and depth of any UUWL apparatus shown on the Map are approximate only. UUWL strongly recommends that a comprehensive survey is undertaken in addition to reviewing this Map to determine and ensure the precise location of any UUWL apparatus. The exact location, positions and depths should be obtained by excavation trial holes.
4. The location and position of private drains, private sewers and service pipes to properties are not normally shown on this Map but their presence must be anticipated and accounted for and you are strongly advised to carry out your own further enquiries and investigations in order to locate the same.
5. The position and depth of UUWL apparatus is subject to change and therefore this Map is issued subject to any removal or change in location of the same. The onus is entirely upon you to confirm whether any changes to the Map have been made subsequent to issue and prior to any works being carried out.
6. This Map and any information shown on it or provided with it must not be relied upon in the event of any development, construction or other works (including but not limited to any excavations) in the vicinity of UUWL apparatus or for the purpose of determining the suitability of a point of connection to the sewerage or other distribution systems.
7. No person or legal entity, including any company shall be relieved from any liability howsoever and whensoever arising for any damage caused to UUWL apparatus by reason of the actual position and/or depths of UUWL apparatus being different from those shown on the Map and any information supplied with it.
8. If any provision contained herein is or becomes legally invalid or unenforceable, it will be taken to be severed from the remaining provisions which shall be unaffected and continue in full force and affect.
9. This agreement shall be governed by English law and all parties submit to the exclusive jurisdiction of the English courts, save that nothing will prevent UUWL from bringing proceedings in any other competent jurisdiction, whether concurrently or otherwise.